



 **RIPARIAN ENHANCEMENT 3.00 ACRES**

 **PRAIRIE CORDGRASS FILTER 0.12 ACRES**

 **MITIGATION POCKETS 0.75 ACRES**

 **EXISTING WETLAND**

 **SIGNAGE**

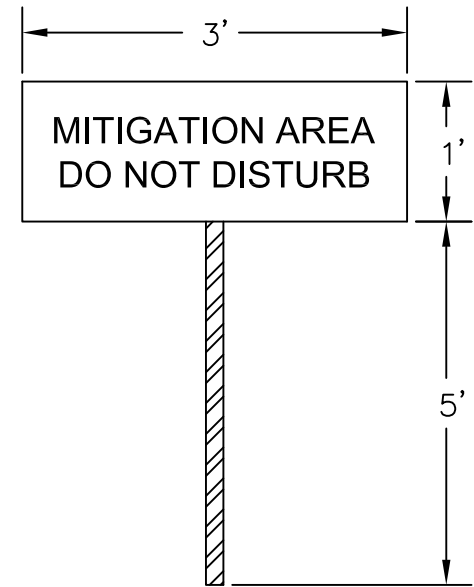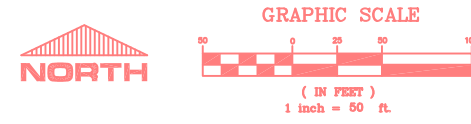


MITIGATION AREA SIGNAGE

AS BUILT

4707 W 135th St, Suite 280
Leawood, Kansas 66224
Tel 913.385.9560 Fax 913.385.5295
terra@terratechtechnologies.com

Terra Technologies

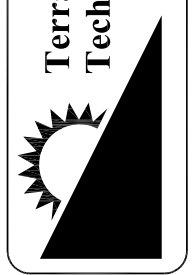

Mitigation Site As-Built - Permit No. 2005-02054

PROJECT
Prairie Farms Development

CLIENT
Prairie Center Development Co.

REVISIONS	
DATE	DESCRIPTION
10/4/07	Changes per DLF

DATE 08/29/07
CHECKED BY DLF **DRAWN BY** JMG
SHEET NO. 4
JOB NO. XXX