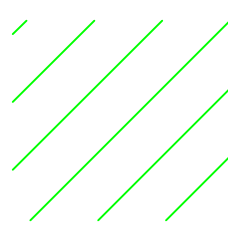

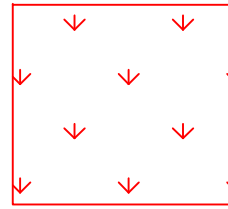
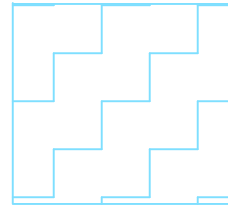
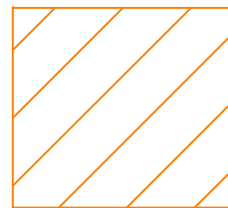

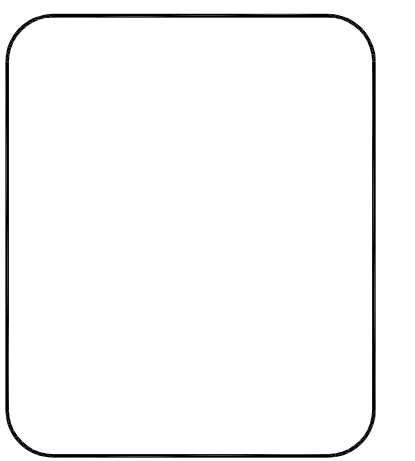


LEGEND

-  EXISTING EMERGENT WETLAND
0.07 ACRE
-  EXISTING EMERGENT LINEAR WETLAND
0.03 ACRE
-  BROAD-LEAVED SCRUB SHRUB & FORESTED WETLAND CREATION
14.80 ACRES
-  PERSISTENT EMERGENT WETLAND CREATION
0.59 ACRE
-  RIPARIAN CORRIDOR CREATION
0.73 ACRE
-  RIPARIAN CORRIDOR PRESERVATION
0.25 ACRE

NOTE: EXISTING 0.10 ACRE OF WETLAND AND 0.25 ACRE OF RIPARIAN CORRIDOR PRESERVATION IS EXCLUDED FROM 16.12 ACRE MITIGATION CALCULATION



SHEET TITLE	MITIGATION SITE AS-BUILT
PROJECT	404 Permit #200501549
CLIENT	Union Pacific

REVISIONS	
DATE	DESCRIPTION